

NOTE:
THE INFORMATION ON THIS PLAN IS COMPILED FROM VARIOUS SOURCES AND SHOULD BE VERIFIED PRIOR TO USE.
LOCATIONS SHOWN ARE APPROXIMATE ONLY AND SHOULD BE VERIFIED IN THE FIELD PRIOR TO WORK COMMENCING.

Table of Revisions

Number	Revision	Date	By
0.	Revised	01-04-19	
	Revised	Oct. 2003	WR/JC
	Revised	June 2004	WR/JC
	Revised	June 2005	WR/JC
	Revised	June 2007	WR
	Revised	Oct. 2008	JM
	Added S-1873 Proposed	Nov. 2010	MLR
	Added S-1716 As Built	Jul. 2014	MLR




The Corporation
of the
City of Windsor

Engineering – Infrastructure & Geomatics



SEWER ATLAS

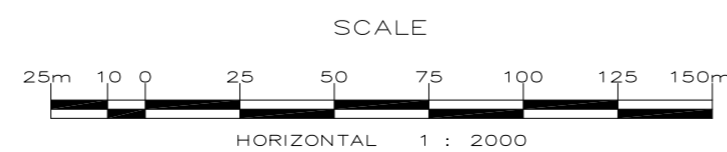

<ul style="list-style-type: none"> --- SANITARY SEWER --- STORM SEWER --- COMBINED SEWER --- PRIVATE SEWER --- SANITARY PROPOSED OR AS BUILT INFO N/A --- STORM PROPOSED OR AS BUILT INFO N/A --- GAS LINE --- STEAM LINE --- HYDRO ONE --- R.O.W. --- ASSESSMENT LOT --- HERB GRAY PKWY LIMITS 	<p>Type</p> <ul style="list-style-type: none"> S-Sanitary R-Storm C-Combined <p>Manhole Location</p> <ul style="list-style-type: none"> 70000 - Manhole Number N/A - North Invert N/A - South Invert 190.00 - East Invert 190.00 - West Invert 190.00 - Top Elevation <p>Pipe Length</p> <ul style="list-style-type: none"> 100.85m 1200mm CP 4 - Pipe Material 	<p>Type</p> <ul style="list-style-type: none"> 70000 - Manhole Number N/A - North Invert N/A - South Invert 190.00 - East Invert 190.00 - West Invert 190.00 - Top Elevation <p>Manhole Location</p> <ul style="list-style-type: none"> 70000 - Manhole Number N/A - North Invert N/A - South Invert 190.00 - East Invert 190.00 - West Invert 190.00 - Top Elevation <p>Storm</p> <ul style="list-style-type: none"> Sanitary
--	---	---

E6	F6	G6
E7	F7	G7
E8	F8	G8