


NOTE:
 THE INFORMATION ON THIS PLAN IS COMPILED FROM VARIOUS SOURCES AND SHOULD BE VERIFIED PRIOR TO USE.
 LOCATIONS SHOWN ARE APPROXIMATE ONLY AND SHOULD BE VERIFIED IN THE FIELD PRIOR TO WORK COMMENCING.

Table of Revisions



J3			
Number	Revision	Date	By
0.	Revised	June 2005	WR/JC
	Revised	June 2007	WR
	Revised	Oct. 2008	JM
	Added S-1923 As-built (RTB)	Jan 2013	MLR
	Added S-1977	Apr 2014	MLR
	Added S-2053	May 2018	NS
	Added S-2056 Proposed	June 2018	NS
	Added S-2046 As-built	Dec. 2018	NS



The Corporation
 of the
 City of Windsor
 Engineering – Infrastructure & Geomatics

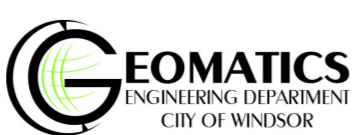

SEWER ATLAS

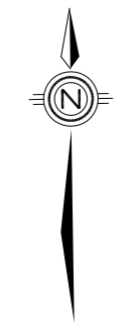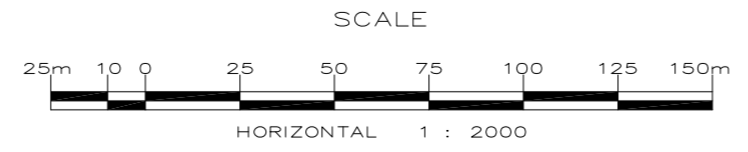

<ul style="list-style-type: none"> SANITARY SEWER STORM SEWER COMBINED SEWER PRIVATE SEWER SANITARY AS BUILT INFO N/A STORM CULVERTS, CATCH BASINS AND OUTLETS GAS LINE STEAM LINE HYDRO ONE R.O.W ASSESSMENT LOT 	<ul style="list-style-type: none"> Manhole Location Manhole Number North Invert South Invert East Invert West Invert Top Elevation 	<ul style="list-style-type: none"> Typical Dual Manhole Manhole Location Manhole Number North Invert South Invert East Invert West Invert Top Elevation
--	---	---

Pipe Length— Pipe Size— Pipe Material
 Type: S=Sanitary, St=Storm, C=Combined
 7R00000— Manhole Number
 7000000— Manhole Number
 S-1000— CONSTRUCTION DWG NUMBER
 HERB GRAY PKWY LIMITS

12	J2	K2
13	J3	K3
14	J4	K4