

NOTE:
THE INFORMATION ON THIS PLAN IS COMPILED FROM VARIOUS SOURCES AND SHOULD BE VERIFIED PRIOR TO USE.
LOCATIONS SHOWN ARE APPROXIMATE ONLY AND SHOULD BE VERIFIED IN THE FIELD PRIOR TO WORK COMMENCING.

Table of Revisions


Number	Revision	Date	By
0.	Revised	Oct. 2003	WR/JC
	Revised	June 2004	WR/JC
	Revised	June 2005	WR/JC
	Revised	June 2007	WR
	Added S-1960 Proposed	Oct. 2013	MLR
	Added S-1871 As-built	Oct. 2013	MLR
	Revised	Oct. 2014	NS
	Added S-1960 As-built	Nov. 2015	MLR



The Corporation
of the
City of Windsor
Engineering – Infrastructure & Geomatics



SEWER ATLAS

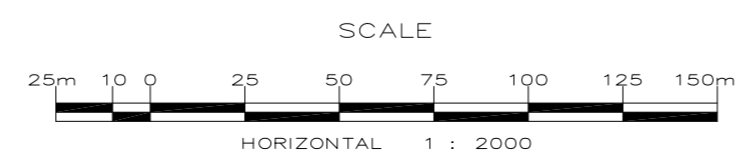

Legend

- SANITARY SEWER (Red dashed line)
- STORM SEWER (Blue dashed line)
- COMBINED SEWER (Green dashed line)
- PRIVATE SEWER (Purple dashed line)
- SANITARY PROPOSED OR AS BUILT INFO (Red solid line)
- STORM (Blue solid line)
- GAS LINE (Orange solid line)
- STEAM LINE (Yellow solid line)
- HYDRO ONE (Light blue solid line)
- R.O.W. (Black solid line)
- ASSESSMENT LOT (Black outline)
- HERB GRAY PKWY LIMITS (Black dashed line)

Manhole Location

- 700000 - Manhole Number
- N/A - North Invert
- N/A - South Invert
- 190.00 - East Invert
- 190.00 - West Invert
- 190.00 - Top Elevation

Typical Dual Manhole

- 700000 - Manhole Number
- N/A - North Invert
- N/A - South Invert
- 190.00 - East Invert
- 190.00 - West Invert
- 190.00 - Top Elevation

Construction DWG Number

- S-1000

Other Symbols: Type (S-Sanitary, R-Storm, C-Combined), Ward, Pipe Length, Pipe Size, Pipe Material

J3	K3	L3
J4	K4	L4
J5	K5	L5