

NOTE:
THE INFORMATION ON THIS PLAN IS COMPILED FROM VARIOUS SOURCES AND SHOULD BE VERIFIED PRIOR TO USE.
LOCATIONS SHOWN ARE APPROXIMATE ONLY AND SHOULD BE VERIFIED IN THE FIELD PRIOR TO WORK COMMENCING.

Table of Revisions


M14			
Number	Revision	Date	By
0.	Revised	01-04-19	
	Revised	03-07-04	
	Revised	Oct. 2003	WR/JC
	Revised	June 2005	WR/JC
	Revised	June 2007	WR
	Added S-1959 As-builts for Phase 3A-2	July 2013	MLR
	Added S-1959 As-builts for Phase 3C	July 2014	MLR
	Added S-2037 As-builts for Phase 3D	June 2016	MLR



The Corporation
of the
City of Windsor
Engineering – Infrastructure & Geomatics



SEWER ATLAS

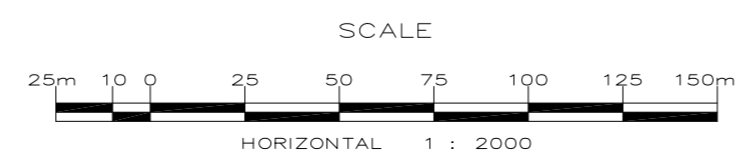

Legend

- SANITARY SEWER (Red dashed line)
- STORM SEWER (Blue dashed line)
- COMBINED SEWER (Green dashed line)
- PRIVATE SEWER (Purple dashed line)
- SANITARY PROPOSED OR AS BUILT INFO N/A (Red dashed line with 'N/A' label)
- STORM (Blue dashed line with 'N/A' label)
- GAS LINE (Yellow dashed line)
- STEAM LINE (Orange dashed line)
- HYDRO ONE (Light blue dashed line)
- R.O.W. (Red dashed line)
- ASSESSMENT LOT (Black dashed line)
- HERB GRAY PKWY LIMITS (Green dashed line)

Manhole Information

Manhole Number: 7R0000
 Manhole Location: 190.00
 Top Elevation: 190.00
 Invert: N/A (North), N/A (South), N/A (East), N/A (West)

Construction Drawing Number

Construction DWG Number: S-1000

L13	M13	N13
L14	M14	N14
L15	M15	N15