

NOTE:  
THE INFORMATION ON THIS PLAN IS COMPILED FROM VARIOUS SOURCES AND SHOULD BE VERIFIED PRIOR TO USE.  
LOCATIONS SHOWN ARE APPROXIMATE ONLY AND SHOULD BE VERIFIED IN THE FIELD PRIOR TO WORK COMMENCING.

Table of Revisions



N13				
Number	Revision	Date	By	
0.	Revised	Oct. 2003	WR/JC	
	Revised	June 2004	WR/JC	
	Revised	June 2005	WR/JC	
	Revised	Nov. 2006	WR/JC	
	Revised	June 2007	WR	
	Added S-1849 As-builts	Jan. 2009	MLR	
	Added S-1959 As-builts for Phase 3A-2	July 2013	MLR	
	Added S-1959 As-builts for Phase 3C	July 2014	MLR	



The Corporation  
of the  
City of Windsor  
Engineering – Infrastructure & Geomatics



# SEWER ATLAS

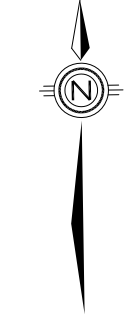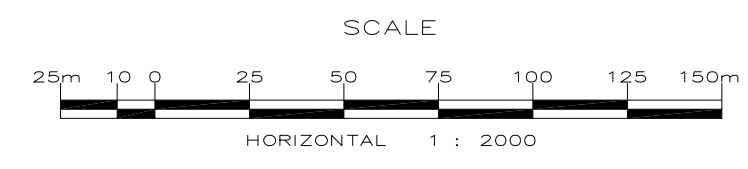

**Legend**

- SANITARY SEWER (Blue dashed line)
- STORM SEWER (Red dashed line)
- COMBINED SEWER (Green dashed line)
- PRIVATE SEWER (Purple dashed line)
- SANITARY PROPOSED OR AS BUILT INFO N/A (Blue dashed line with 'P')
- STORM PROPOSED OR AS BUILT INFO N/A (Red dashed line with 'P')
- GAS LINE (Yellow dashed line)
- STEAM LINE (Orange dashed line)
- HYDRO ONE (Light blue dashed line)
- R.O.W. (Red dashed line)
- ASSESSMENT LOT (Black dashed line)
- HERB GRAY PKWY LIMITS (Black dashed line)

**Manhole Location**

- 7R0000 - Sanitary
- 7S0000 - Storm
- 7C0000 - Combined
- 7P0000 - Proposed
- 7N0000 - North Invert
- 7S0000 - South Invert
- 7E0000 - East Invert
- 7W0000 - West Invert
- 7T0000 - Top Elevation

**Typical Dual Manhole**

- 7R0000 - Sanitary
- 7S0000 - Storm
- 7C0000 - Combined
- 7N0000 - North Invert
- 7S0000 - South Invert
- 7E0000 - East Invert
- 7W0000 - West Invert
- 7T0000 - Top Elevation

**Construction DWG Number**

- S-1000 - Sanitary
- S-1000 - Storm

M12	N12	O12
M13	<b>N13</b>	O13
M14	N14	O14