



NOTE:  
THE INFORMATION ON THIS PLAN IS COMPILED FROM VARIOUS SOURCES AND SHOULD BE VERIFIED PRIOR TO USE.  
LOCATIONS SHOWN ARE APPROXIMATE ONLY AND SHOULD BE VERIFIED IN THE FIELD PRIOR TO WORK COMMENCING.

Table of Revisions


04			
Number	Revision	Date	By
0.	Revised	01-04-19	
	Revised	03-07-04	
	Revised	Oct. 2003	WR/JC
	Revised	June 2004	WR/JC
	Revised	June 2005	WR/JC
	Revised	June 2007	WR
	Added S-1796 As Built	Feb. 2015	MLR
	Added S-2002	Oct. 2015	MLR



The Corporation  
of the  
City of Windsor  
Engineering – Infrastructure & Geomatics



# SEWER ATLAS

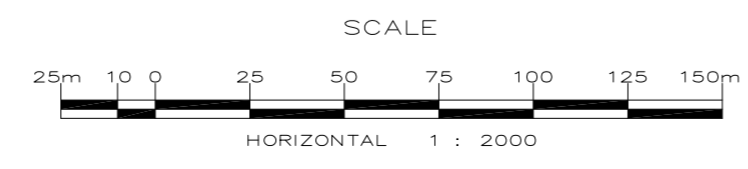

<ul style="list-style-type: none"> <li><span style="color: red;">—</span> SANITARY SEWER</li> <li><span style="color: blue;">—</span> STORM SEWER</li> <li><span style="color: green;">—</span> COMBINED SEWER</li> <li><span style="color: purple;">—</span> PRIVATE SEWER</li> <li><span style="color: magenta;">—</span> SANITARY PROPOSED OR AS BUILT INFO N/A</li> <li><span style="color: cyan;">—</span> STORM</li> <li><span style="color: orange;">—</span> GAS LINE</li> <li><span style="color: brown;">—</span> STEAM LINE</li> <li><span style="color: grey;">—</span> HYDRO ONE</li> <li><span style="color: black;">—</span> R.O.W</li> <li><span style="border: 1px solid black; display: inline-block; width: 10px; height: 10px;"></span> ASSESSMENT LOT</li> <li><span style="border: 1px dashed black; display: inline-block; width: 10px; height: 10px;"></span> HERB GRAY PKWY LIMITS</li> </ul>	<p>Type</p> <ul style="list-style-type: none"> <li>S-Sanitary</li> <li>R-Storm</li> <li>C-Combined</li> </ul> <p>Manhole Location</p> <ul style="list-style-type: none"> <li>700000 Manhole Number</li> <li>N/A North Invert</li> <li>N/A South Invert</li> <li>190.00 East Invert</li> <li>190.00 West Invert</li> <li>190.00 Top Elevation</li> </ul> <p>Pipe Length Pipe Size Pipe Material</p> <ul style="list-style-type: none"> <li>100.85m 1200mm CP</li> <li>4" Pipe Material</li> </ul>	<p>Type</p> <ul style="list-style-type: none"> <li>Typical Dual Manhole</li> </ul> <p>Manhole Location</p> <ul style="list-style-type: none"> <li>700000 Manhole Number</li> <li>N/A North Invert</li> <li>N/A South Invert</li> <li>190.00 East Invert</li> <li>190.00 West Invert</li> <li>190.00 Top Elevation</li> </ul> <p>Storm Sanitary</p>
--	--	--

N3	O3	P3
N4	O4	P4
N5	O5	P5