

NOTE:
 THE INFORMATION ON THIS PLAN IS COMPILED FROM VARIOUS SOURCES AND SHOULD BE VERIFIED PRIOR TO USE.
 LOCATIONS SHOWN ARE APPROXIMATE ONLY AND SHOULD BE VERIFIED IN THE FIELD PRIOR TO WORK COMMENCING.

Table of Revisions

Number	Revision	Date	By
	R2		
	Revised	June 2005	WR/JC
	Revised	June 2007	WR
	Revised To Show Edge of Pavement 2006	July 2007	WR
	Revised	Oct. 2008	JM
	Added S-1894 Proposed	Apr 2010	MLR
	Revised Little River Treatment Plant Area	Nov 2010	MLR
	Added S-1894 As-built	Jan 2011	MLR
	Added S-1872 and P-1917 As-Built	Jan 2012	MLR
	Added S-1625 As-Built	Mar 2012	MLR


Q1	R1	S1
Q2	R2	S2
Q3	R3	S3



The Corporation
 of the
 City of Windsor
 Engineering – Infrastructure & Geomatics



SEWER ATLAS

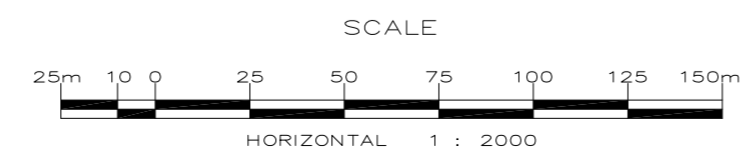

Legend

- SANITARY SEWER (Red dashed line)
- STORM SEWER (Blue dashed line)
- COMBINED SEWER (Green dashed line)
- PRIVATE SEWER (Purple dashed line)
- SANITARY PROPOSED OR AS BUILT INFO (Red solid line)
- STORM (Blue solid line)
- GAS LINE (Orange solid line)
- STEAM LINE (Yellow solid line)
- HYDRO ONE (Light Blue solid line)
- R.O.W. (Black solid line)
- ASSESSMENT LOT (Black solid line)
- HERB GRAY PKWY LIMITS (Yellow dashed line)

Manhole Location

- 70000 - Manhole Number
- N/A - North Invert
- N/A - South Invert
- 190.00 - East Invert
- 190.00 - West Invert
- 190.00 - Top Elevation

Typical Dual Manhole

- 70000 - Manhole Number
- N/A - North Invert
- N/A - South Invert
- 190.00 - East Invert
- 190.00 - West Invert
- 190.00 - Top Elevation

Construction DWG Number

- S-1000 - Construction DWG Number

Other Symbols

- Ward
- Sanitary
- Storm
- Combined
- Manhole Location
- Pipe Length
- Pipe Size
- Pipe Material