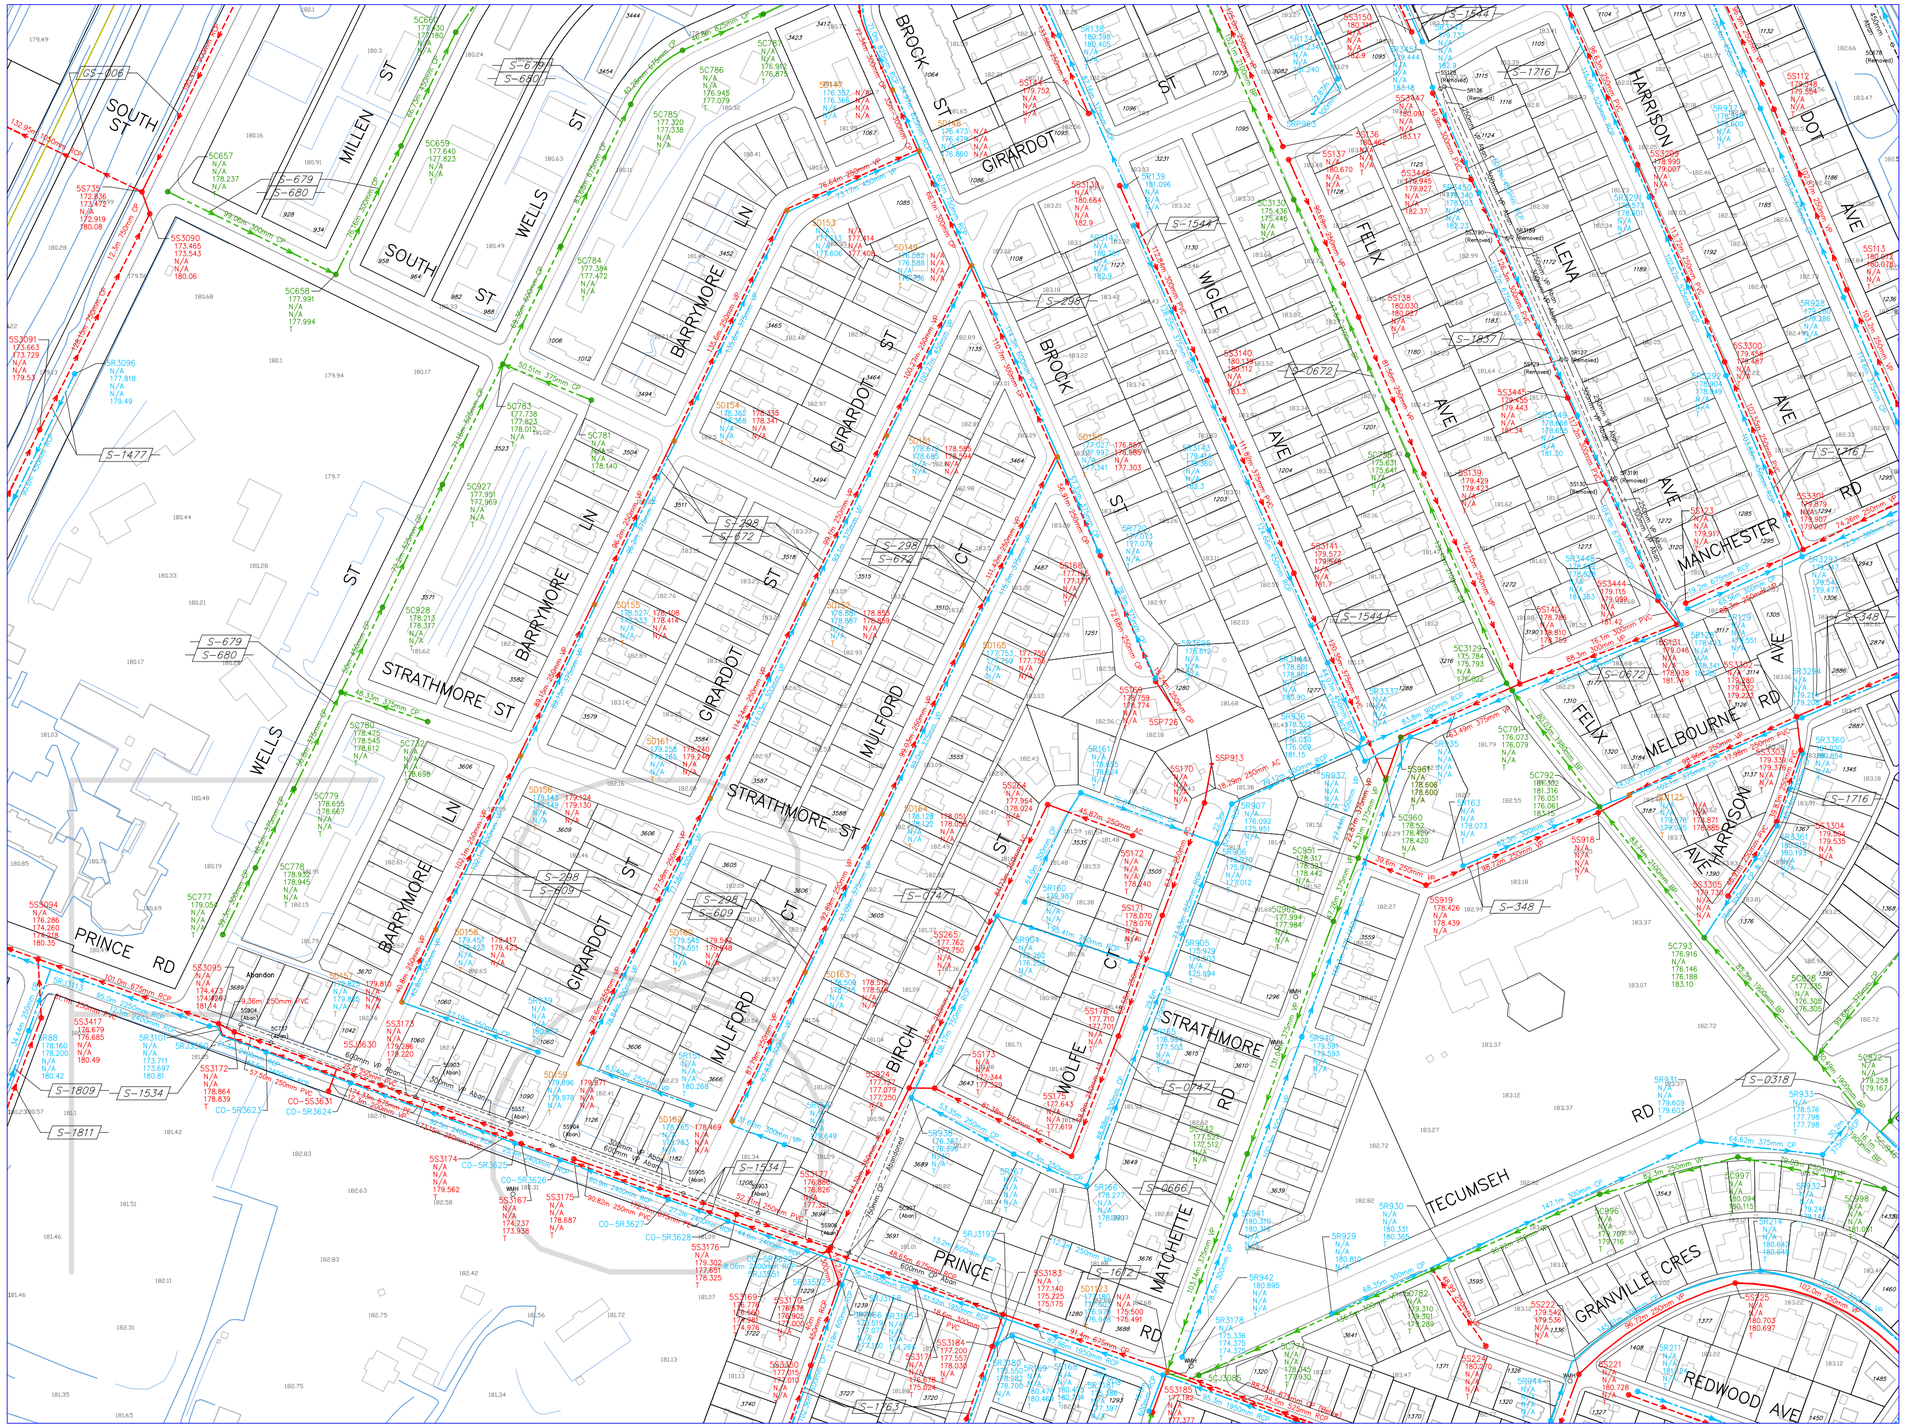

The Corporation of the City of Windsor

Engineering – Infrastructure & Geomatics

GEOMATICS ENGINEERING DEPARTMENT CITY OF WINDSOR

SEWER ATLAS

SCALE

25m 10 0 25 50 75 100 125 150m

HORIZONTAL 1 : 2000

SANITARY SEWER
STORM SEWER
COMBINED SEWER
PRIVATE SEWER
PROPOSED OR AS BUILT INFO N/A
SANITARY
STORM
GAS LINE
STEAM LINE
HYDRO ONE
R.O.W
ASSESSMENT LOT
HERB GRAY PKWY LIMITS

Type: S=Sanitary R=Storm C=Combined
Ward
Manhole Location
700000 Manhole Number
N/A North Invert
N/A South Invert
190.00 East Invert
190.00 West Invert
Top Elevation
100.85m 1200mm CP
Pipe Length — Pipe Size — Pipe Material
Type: Typical Dual Manhole
Storm / Sanitary
S-1000 CONSTRUCTION DWG NUMBER

NOTE:
THE INFORMATION ON THIS PLAN IS COMPILED FROM VARIOUS SOURCES AND SHOULD BE VERIFIED PRIOR TO USE.

LOCATIONS SHOWN ARE APPROXIMATE ONLY AND SHOULD BE VERIFIED IN THE FIELD PRIOR TO WORK COMMENCING.

Table of Revisions

F8

Number	Revision	Date	By
0.	Revised	03-04-14	
	Revised	Oct. 2003	WR/JC
	Revised	June 2004	WR/JC
	Revised	June 2005	WR/JC
	Revised	June 2007	WR
	Added Lena Ave Sewers to Proposed Layer	Dec 2008	MLR
	Added S-1716 As Built	Jul 2014	MLR
	Added S-1837 As Built	May 2015	MLR

E7	F7	G7
E8	**F8**	G8
E9	F9	G9