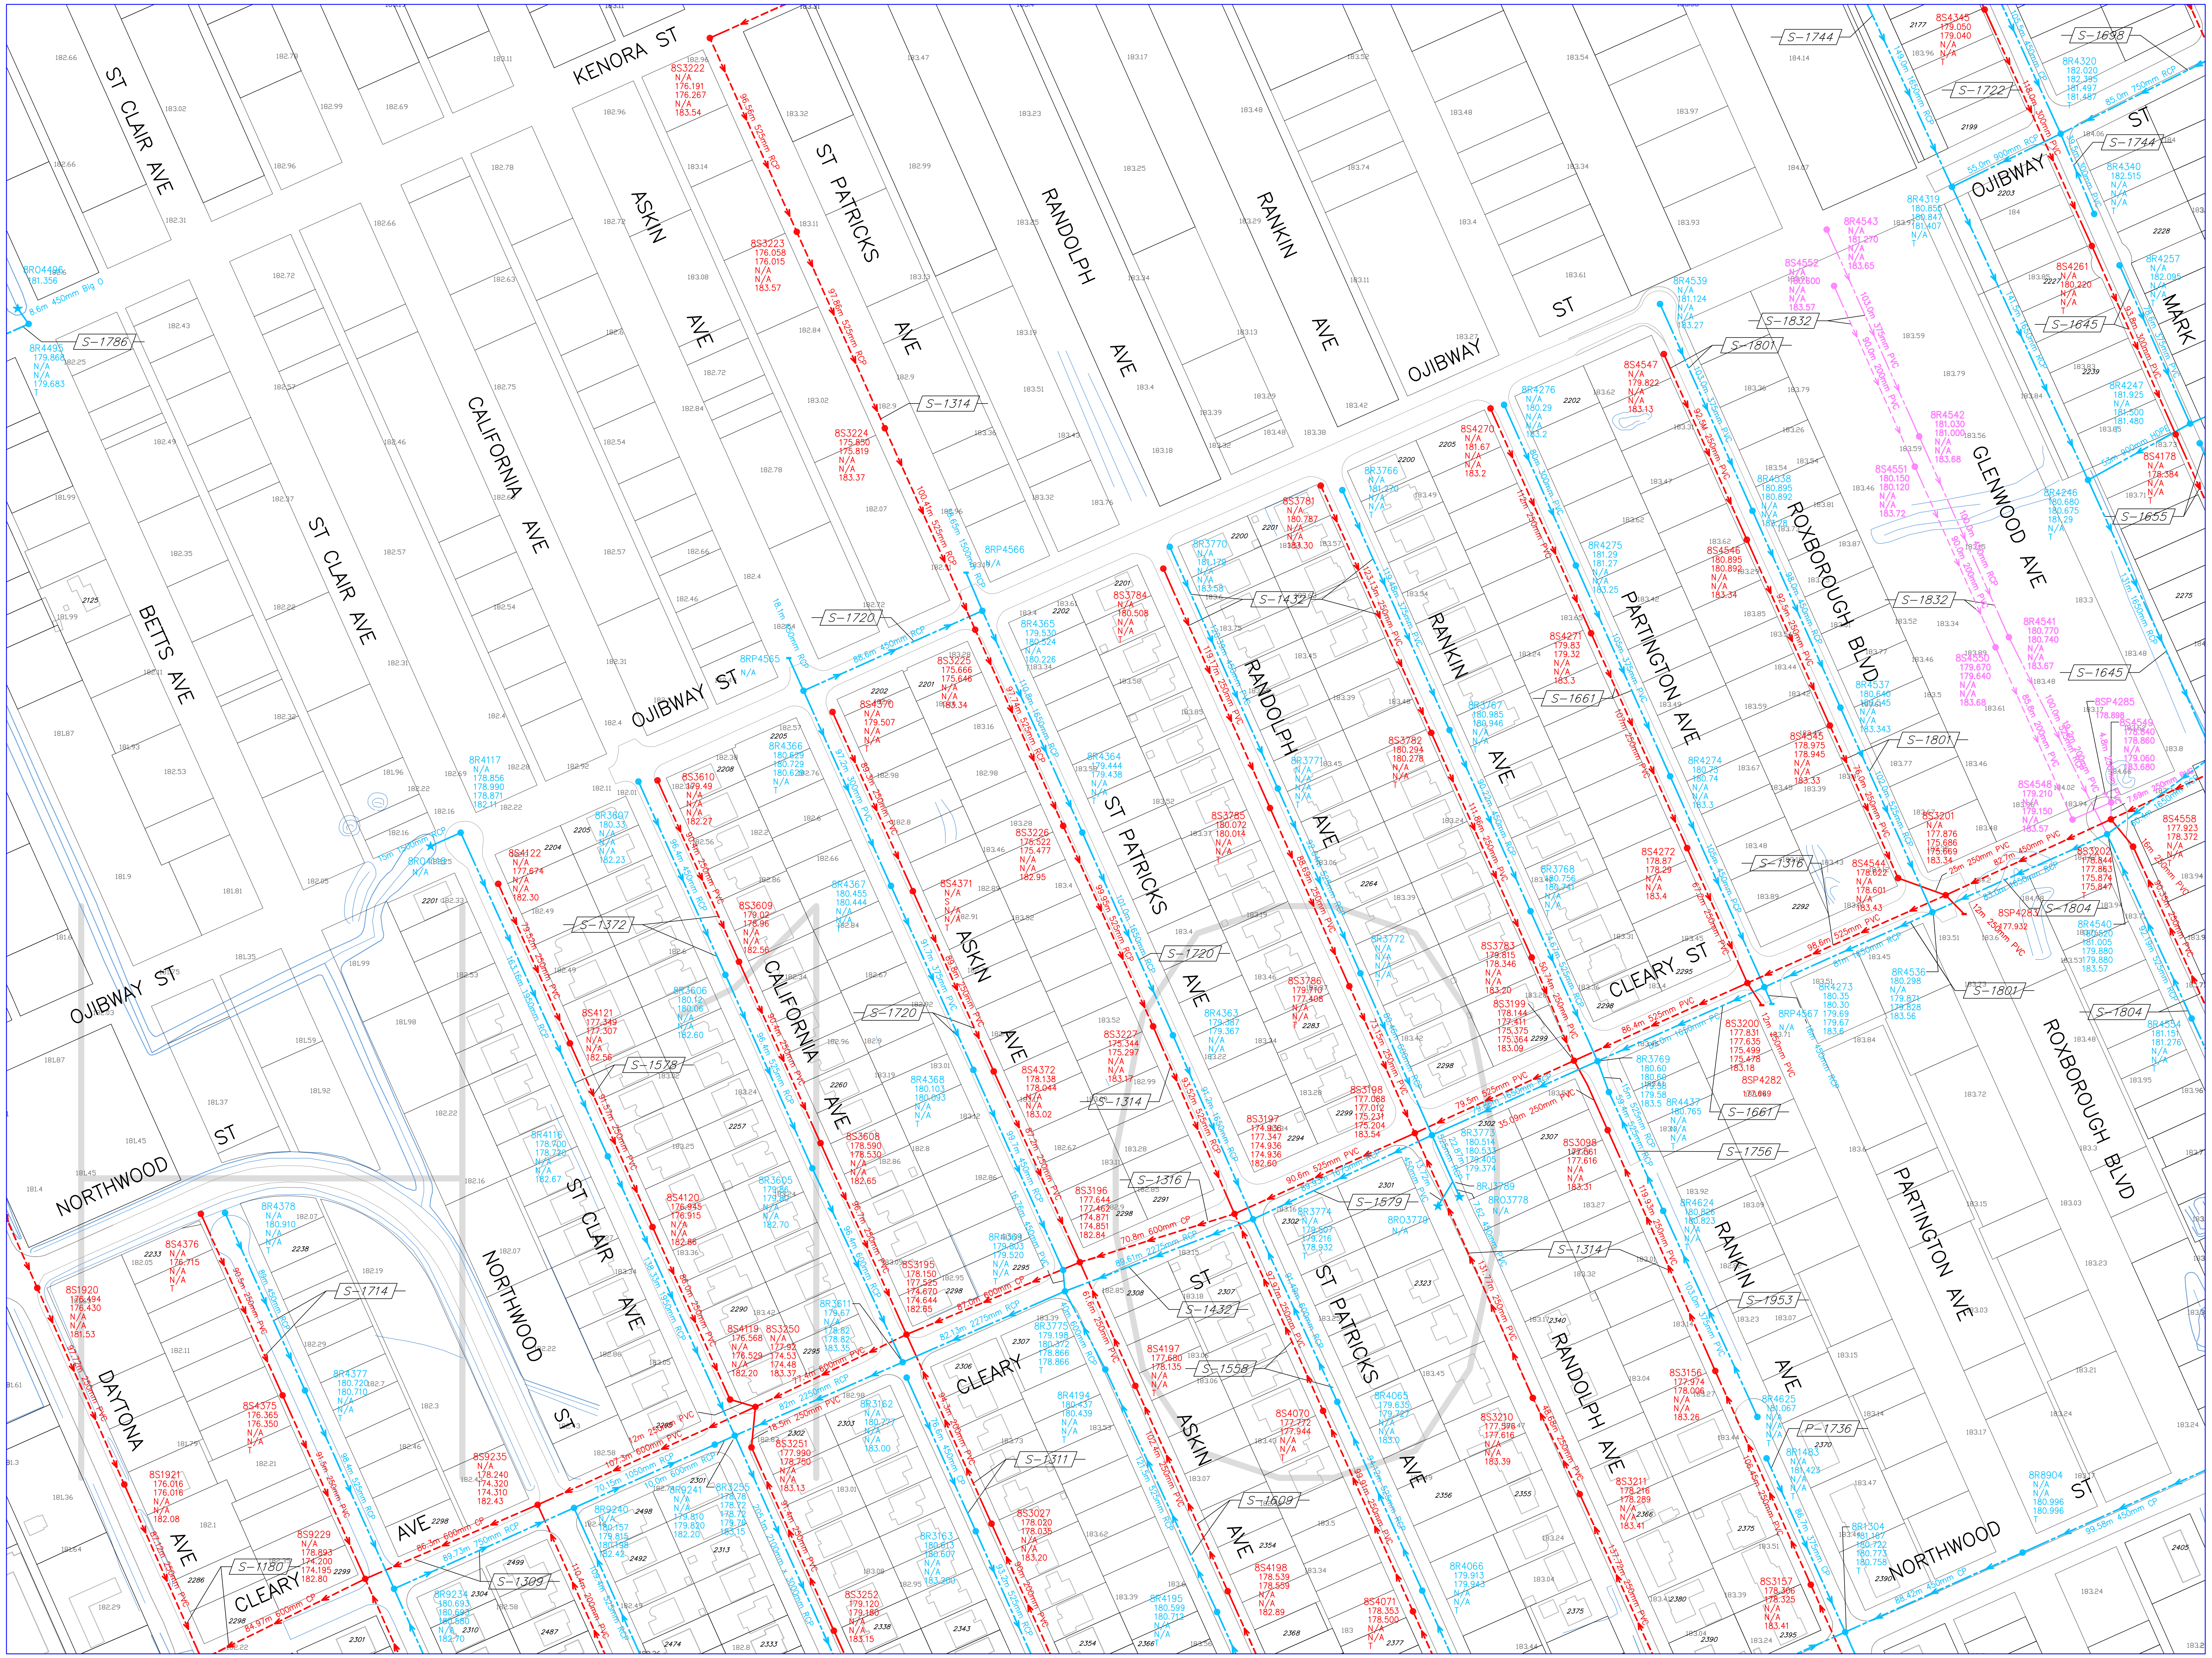

SEWER ATLAS

SCALE

25m 10 0 25 50 75 100 125 150m

HORIZONTAL 1 : 2000

The Corporation of the City of Windsor

Engineering – Infrastructure & Geomatics

GEOMATICS ENGINEERING DEPARTMENT CITY OF WINDSOR

SANITARY SEWER
STORM SEWER
COMBINED SEWER
PRIVATE SEWER
SANITARY / STORM — PROPOSED OR AS BUILT INFO N/A
GAS LINE
STEAM LINE
HYDRO ONE
R.O.W
ASSESSMENT LOT
HERB GRAY PKWY LIMITS

Type: S=Sanitary, R=Storm, C=Combined
Ward — 7R0000 — Manhole Number; N/A — North Invert; N/A — South Invert; 190.00 — East Invert; 190.00 — West Invert; T — Top Elevation; Manhole Location

Type: Typical Dual Manhole
Ward — 7D0000 — Manhole Number; North Invert N/A N/A; South Invert N/A N/A; East Invert 190.00 190.00; West Invert 190.00 190.00; T — Top Elevation; Storm / Sanitary; Manhole Location

100.85m 1200mm CP — Pipe Length, Pipe Size, Pipe Material

S-1000 — CONSTRUCTION DWG NUMBER

NOTE:
THE INFORMATION ON THIS PLAN IS COMPILED FROM VARIOUS SOURCES AND SHOULD BE VERIFIED PRIOR TO USE.

LOCATIONS SHOWN ARE APPROXIMATE ONLY AND SHOULD BE VERIFIED IN THE FIELD PRIOR TO WORK COMMENCING.

Table of Revisions

H10			
Number	Revision	Date	By
0.	Revised	Oct. 2003	WR/JC
	Revised	June 2004	WR/JC
	Revised	June 2005	WR/JC
	Revised	June 2007	WR
	Added S-1832 Proposed	June 2007	WR
		May 2013	WR
	Added S-1965 Proposed	July 2013	MLR
	S-1953 As-built	May 2014	MLR

G9	H9	I9
G10	**H10**	I10
G11	H11	I11