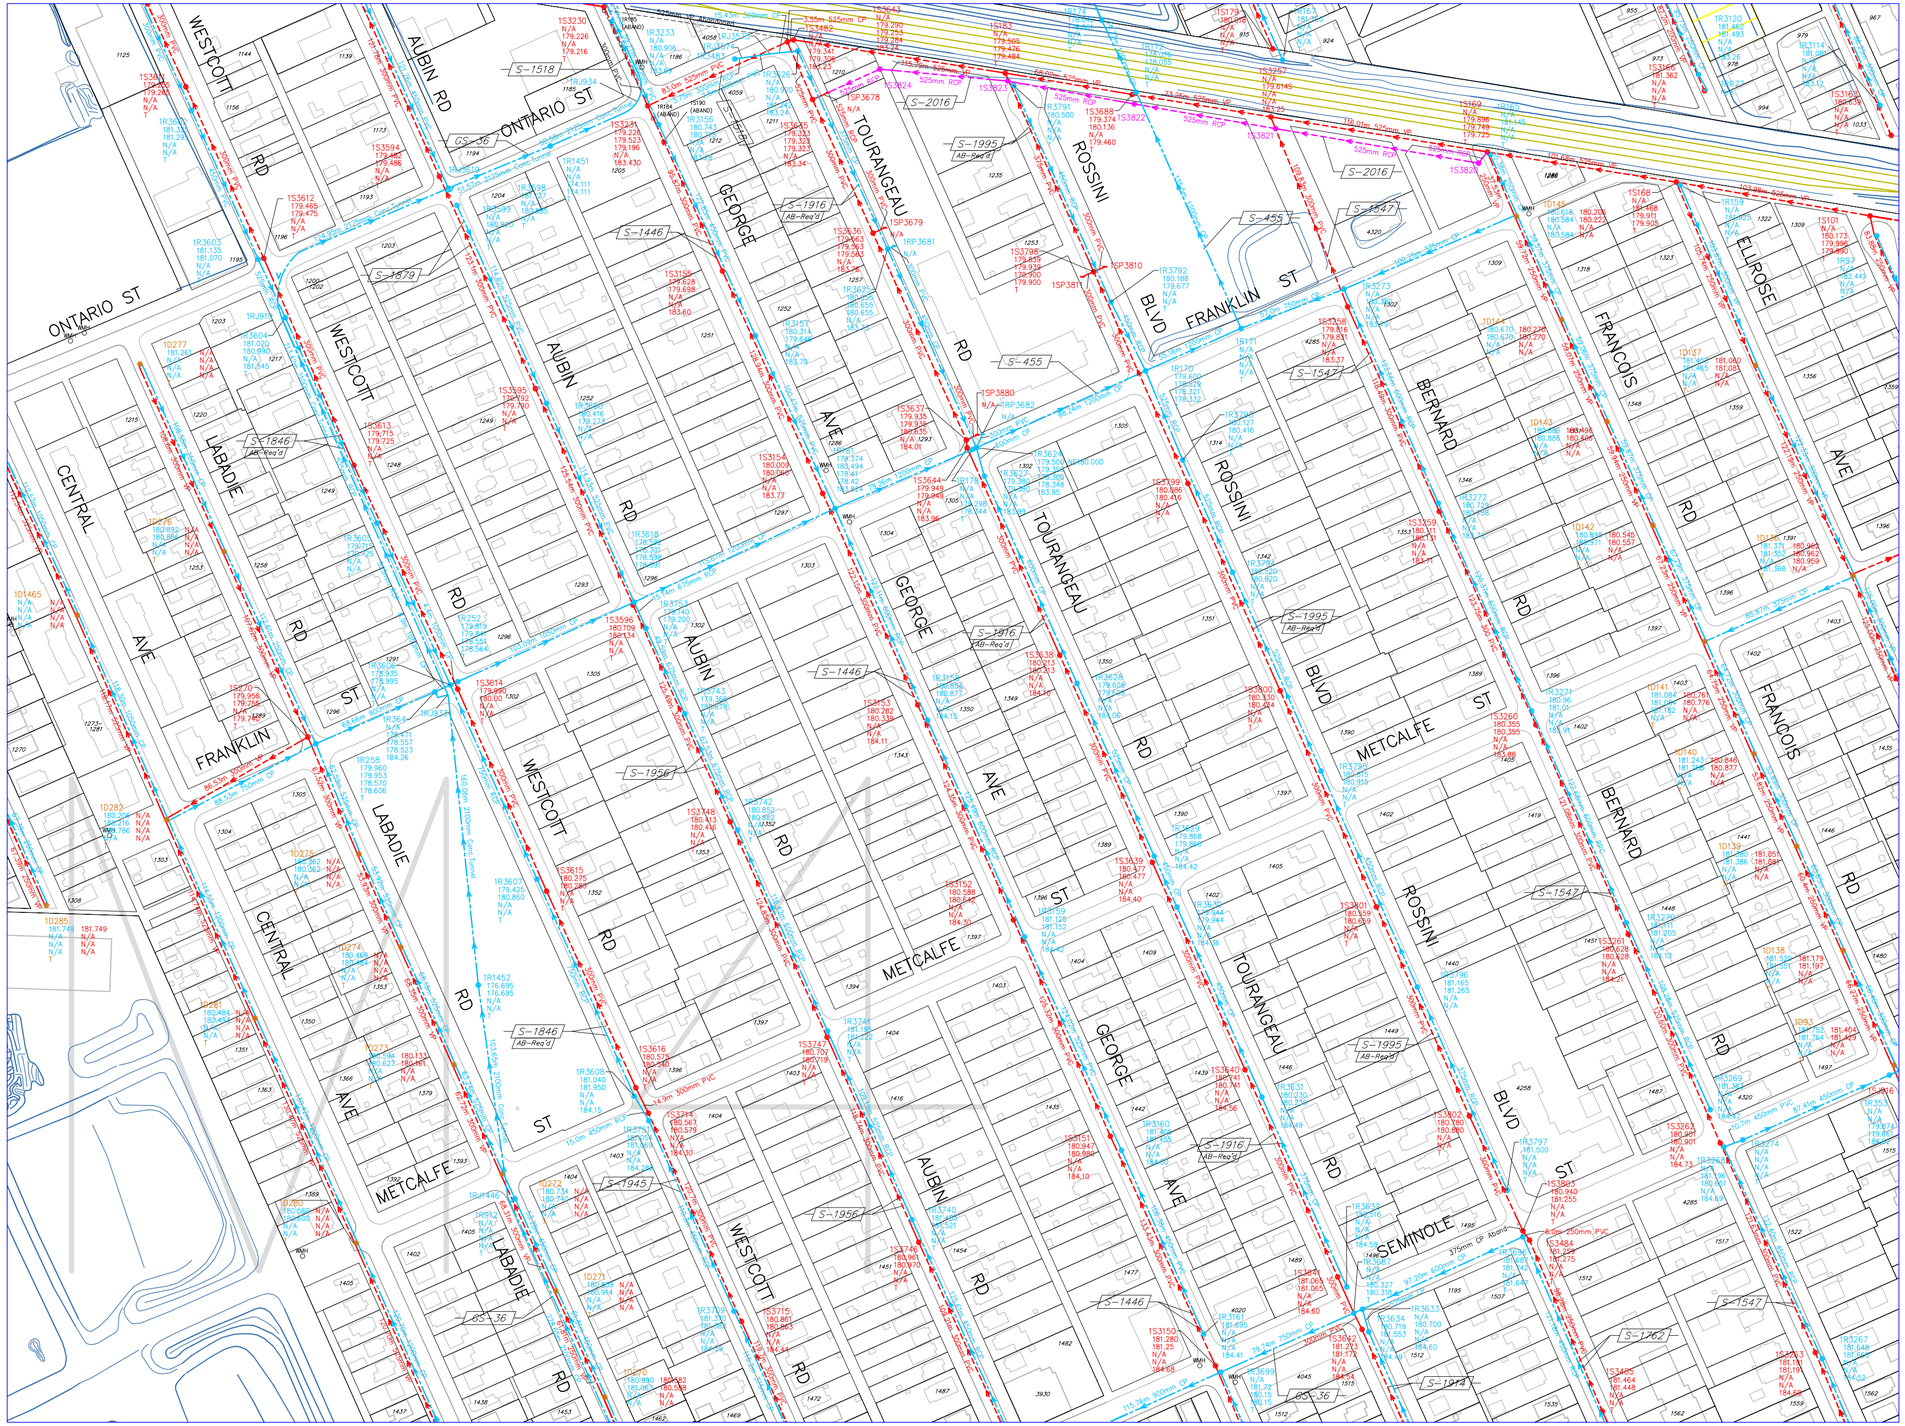

The Corporation of the City of Windsor

Engineering – Infrastructure & Geomatics

GEOMATICS ENGINEERING DEPARTMENT CITY OF WINDSOR

SEWER ATLAS

SCALE

25m 10 0 25 50 75 100 125 150m

HORIZONTAL 1 : 2000

SANITARY SEWER
STORM SEWER
COMBINED SEWER
PRIVATE SEWER
SANITARY
STORM
PROPOSED OR AS BUILT INFO N/A
GAS LINE
STEAM LINE
HYDRO ONE
R.O.W
ASSESSMENT LOT
HERB GRAY PKWY LIMITS

Type
S=Sanitary
R=Storm
C=Combined
Ward
Manhole Location
7R0000 Manhole Number
N/A North Invert
N/A South Invert
190.00 East Invert
190.00 West Invert
T Top Elevation
100.85m 1200mm CP
Pipe Length
Pipe Size
Pipe Material

Type
Typical Dual Manhole
Ward
Manhole Location
700000 Manhole Number
N/A North Invert
N/A South Invert
190.00 East Invert
190.00 West Invert
T Top Elevation
Storm
Sanitary

S-1000 CONSTRUCTION DWG NUMBER

NOTE:
THE INFORMATION ON THIS PLAN IS COMPILED FROM VARIOUS SOURCES AND SHOULD BE VERIFIED PRIOR TO USE.

LOCATIONS SHOWN ARE APPROXIMATE ONLY AND SHOULD BE VERIFIED IN THE FIELD PRIOR TO WORK COMMENCING.

Table of Revisions

M4

Number	Revision	Date	By
0.	Added S-1846 & S-1879 Proposed	June 2010	MLR
	Added S-1762 As-built	June 2013	MLR
	Added S-1956	Aug 2013	MLR
	Added S-1914 As-built	June 2014	MLR
	Added S-1879 and S-1956 As-builts	Sep 2014	MLR
	Added S-1945 As-built	Sep 2014	MLR
	Added S-1995 Proposed	June 2015	MLR
	Added S-2016 Proposed	May 2016	MLR

L3	M3	N3
L4	**M4**	N4
L5	M5	N5